


DO NOT SCALE THIS DRAWING.

DRAWING APPROVAL			
NAME	ORGANISATION	SIGN	DATE

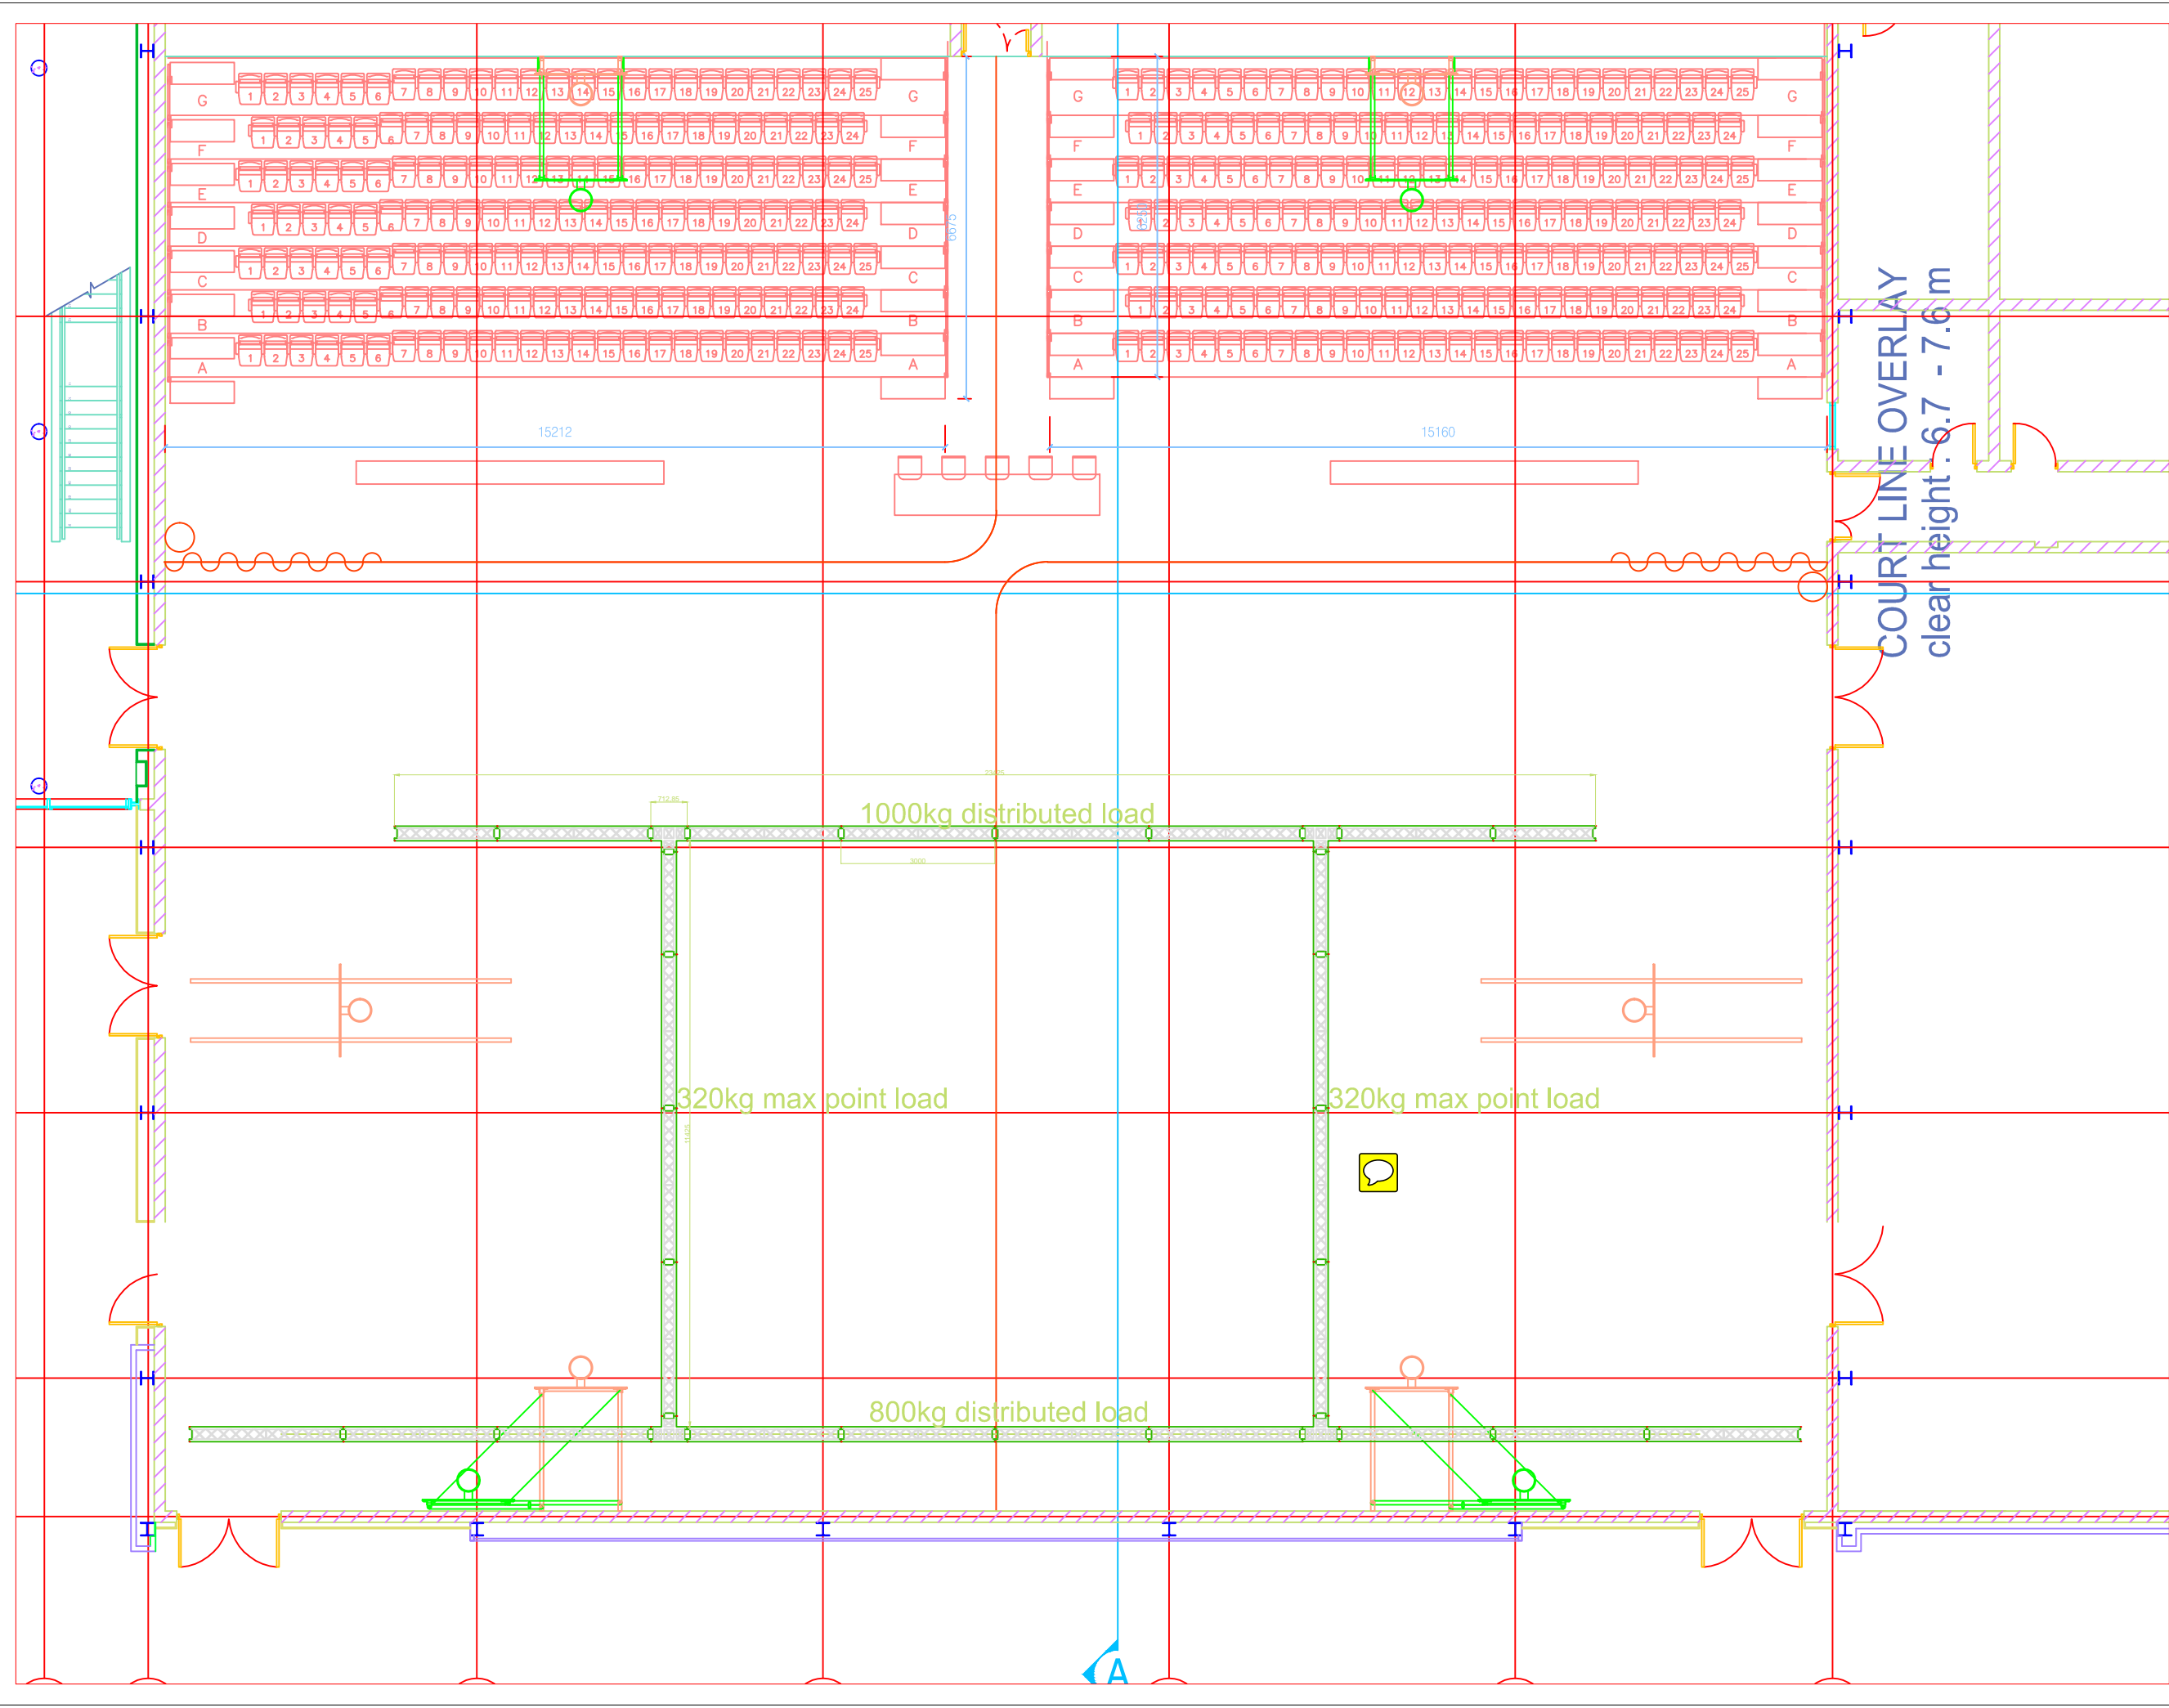

Rev	Description	Drawn	Checked	Date
00	As Built	DCW	GL	17/10/2012

SAFETY, HEALTH AND ENVIRONMENT INFORMATION
Based on the use of experienced and competent contractors working to an approved method statement for structural steelwork, risks are listed below or the statement 'NO UNUSUAL RISKS'

Activity	Risk Level
Construction	NO UNUSUAL RISKS
Operations	NO UNUSUAL RISKS
Maintenance	NO UNUSUAL RISKS
Dismantling / Demolition	NO UNUSUAL RISKS

Client: _____



Project Title
Knocknarea Truss
Sligo

Drawing Title
Groundplan

Drawn	Checked	Approved
DCW	GL	DCW
Scale (A3)	Date	Status
NTS	17/10/2012	As Built
Drawing No.	Rev.	
	00	